


SHOPCORE
 PLANNING
 APPROVED AS NOTED
 APPROVED AS NOTED
 REVISE AND RESUBMIT
 REJECTED
Shelley Roberts
 PROJECT ARCHITECT
 10077 WATSON ROAD
 SUITE 1005, HOUSTON, TX 77020
 (713) 865-1100
 www.shopcoreplanning.com

Project: **DOLLAR TREE**
 INGRAM HILLS
 6020 INGRAM ROAD, SAN ANTONIO, TX 78220
 Drawing: **FIXTURE AND EGRESS PLAN**

FOR INFORMATION ONLY
 NOT TO BE USED FOR CONSTRUCTION



Project: 04/21/16
 Project: 5/16/16
 Designed: RAB
 Drawn: RAB
 Checked: RAB
 Date: 04/21/16
 Revisions:
 Mark: date
 Description

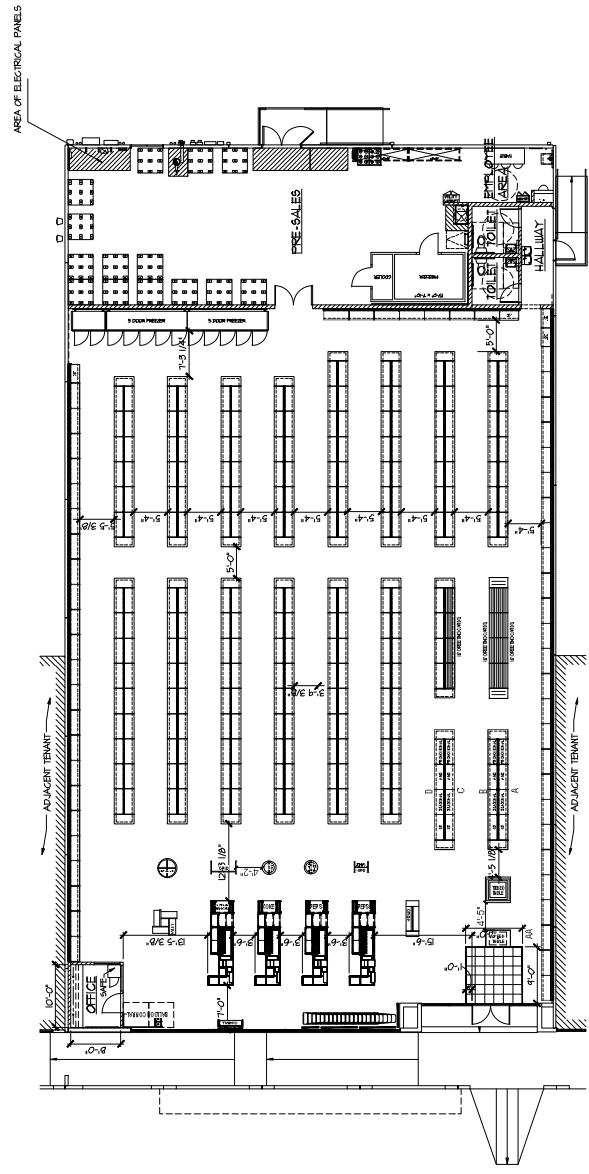

SALES FIXTURE PLAN
 SCALE: 1/8"=1'-0"