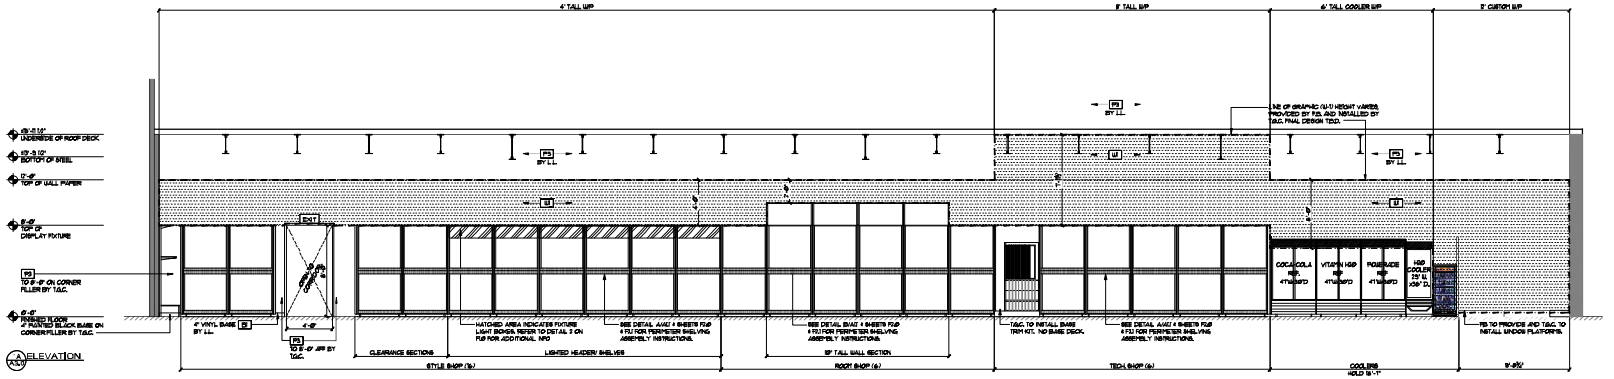

NOTE:
1. WALLPAPER IS PROVIDED BY FIVE BELOW & INSTALLED BY T&C.
2. DO NOT CUT WALLPAPER UNLESS SPECIFICALLY NOTED
3. WALLS ABOVE WALLPAPER LINE TO BE PAINTED P-3.
4. ALL INTERIOR FINISHES SHALL BE CLASS 'A' PER NFPA 259 FLAME SPREAD RATING OF 25 OR LESS WITH NO SMOKE GENERATION FACTOR OF 450.
   a. T&C. TO SUPPLY AND INSTALLED BATTERIES FOR SECURITY CAMERAS.

NOTE:
ALL WALLS BEHIND SALES AREA SHELVING NEED NOT TO BE PAINTED. PAINT THESE WALLS FROM 7'-6" x UP (GOV.)

WALLPAPER NOTE:
1. ALIGN ALL WALLPAPER B/P AT 0'-0" AFF. U.O.N.
2. T&C. TO REFER TO VENDOR PROVIDED WALLPAPER LAYOUT INCLUDED WITH THE WALLPAPER MATERIAL PRIOR TO INSTALLATION.
3. RESTROOM ELEVATION (SHEET 8) IS FOR GRAPHICAL PURPOSES ONLY. REFER TO RESTROOM ELEVATION ON (SHEET) FOR ADDITIONAL INFO

1 INTERIOR ELEVATIONS

SCALE: 1/4" = 1'-0"

FINISH	DESCRIPTION / LOCATION	MANUFACTURER	SPECIFICATION / FINISH	COLOR *
P1	POLISHED CONCRETE OVER EXIST. SLABS. SEE FINISH NOTES FOR SCOPE.	GUESTMARK CONC. POLISHING SYSTEM	----------	----------
F2	12" X 12" X 1/8" VCT	ARMSTRONG	FIELD GRAY: 49/51 & 5-939 ADHESIVE	51821
F3	POLISHED CONCRETE	GUESTMARK CONC. POLISHING SYSTEM	----------	----------
F4	FATIGUE MAT AT CASH WRAP	PROVIDED BY TENANT	----------	----------
F5	SHEET VINYL	ARMSTRONG	WHITE CLIFFS & 5-943 ADHESIVE	56722
B1	4" VINYL BASE	ARMSTRONG	49 JET BLACK	
C1	CEILING DECK OPEN TO JOISTS ABOVE NO HUNG CEILING	SHERWIN WILLIAMS LOW VOC WATERBORNE	FLAT	SW-7069
C2	~~GYP. BD. CEILING~~	~~SHERWIN WILLIAMS~~	~~EGGSHELL~~	~~SW-7069~~
C3	GYP. BD. CEILING	SHERWIN WILLIAMS PROMAR 200 ZERO VOC	56711-GLOSS	SW-7069
P1	PURE WHITE	SHERWIN WILLIAMS LOW VOC WATERBORNE	FLAT	SW-7069
P2	PURE WHITE	SHERWIN WILLIAMS PROMAR 200 ZERO VOC	56711-GLOSS	SW-7069
P3	PURE WHITE	SHERWIN WILLIAMS PROMAR 200 ZERO VOC	EGGSHELL	SW-7069

FINISH	DESCRIPTION / LOCATION	MANUFACTURER	SPECIFICATION / FINISH	COLOR *
P4	RED (NEW 4 NOW)	SHERWIN WILLIAMS PROMAR 200 ZERO VOC	EGG SHELL	SW-6864 *
P5	GREEN (SPORTS)	SHERWIN WILLIAMS PROMAR 200 ZERO VOC	EGG SHELL	SW-6434 *
P6	YELLOW (CREATE)	SHERWIN WILLIAMS PROMAR 200 ZERO VOC	EGG SHELL	SW-6672 *
P7	BLUE (ROOM)	SHERWIN WILLIAMS PROMAR 200 ZERO VOC	EGG SHELL	SW-6736 *
P8	PURPLE (TECH)	SHERWIN WILLIAMS PROMAR 200 ZERO VOC	EGG SHELL	SW-6664 *
P10	MAGENTA (STYLE + BEAUTY)	SHERWIN WILLIAMS PROMAR 200 ZERO VOC	EGG SHELL	SW-6842 *
P11	ORANGE (CANDY + SNACKS)	SHERWIN WILLIAMS PROMAR 200 ZERO VOC	EGG SHELL	SW-6606 *
P12	LIGHT GREEN (PARTY)	SHERWIN WILLIAMS PROMAR 200 ZERO VOC	EGG SHELL	SW-6760 *
P13	LIGHT BLUE (PLAY)	SHERWIN WILLIAMS PROMAR 200 ZERO VOC	EGG SHELL	SW-6538 *
W1	WALLPAPER	TBD	CUSTOM	----------

* FIVE BELOW CUSTOM SHERWIN WILLIAMS COLORS

NOTE: FOR ALL INTERIOR CORNER FILLER PAINT, PLEASE COORDINATE W/ A/D FINISH PLAN

INTERIOR FINISH RATING:
ALL INTERIOR FINISHES SHALL BE CLASS 'A' PER NFPA 259 FLAME SPREAD RATING OF 25 OR LESS WITH MAXIMUM SMOKE GENERATION FACTOR OF 450.

A PAINT FINISH LEGEND / NOTES

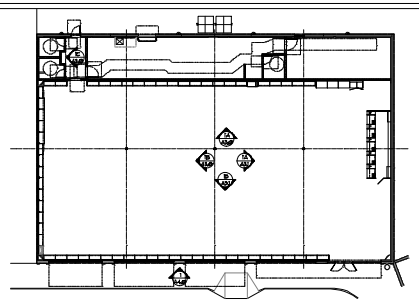

B KEY PLAN

SCALE: N.T.S.

C OPEN

pdms
design development services

CONSULTANTS

mrb
MICHAEL R. BLACK, AIA

SEAL

DATE ISSUE

	DATE	REVISION
1	10.13.17	CITY/ST. COMMENTS

PROJECT NAME / LOCATION

FIVE BELOW
ARBOR PARK SHOPPING CENTER
17700 SAN PEDRO AVE., SUITE 702
SAN ANTONIO, TX 78232

"ROBC" INFORMATION

DATE: 09-07-17
PROJECT NO.: 170123
DELIVERY TYPE: WORK
DRAWN BY: MD
CHECKED BY: MRB

SHEET TITLE / NUMBER

INTERIOR ELEVATIONS

A3.0